


IDEAL PROFESSIONAL PARK

SUITE A-105: As-builts


SCALE: 1/8"=1'

672 sqft

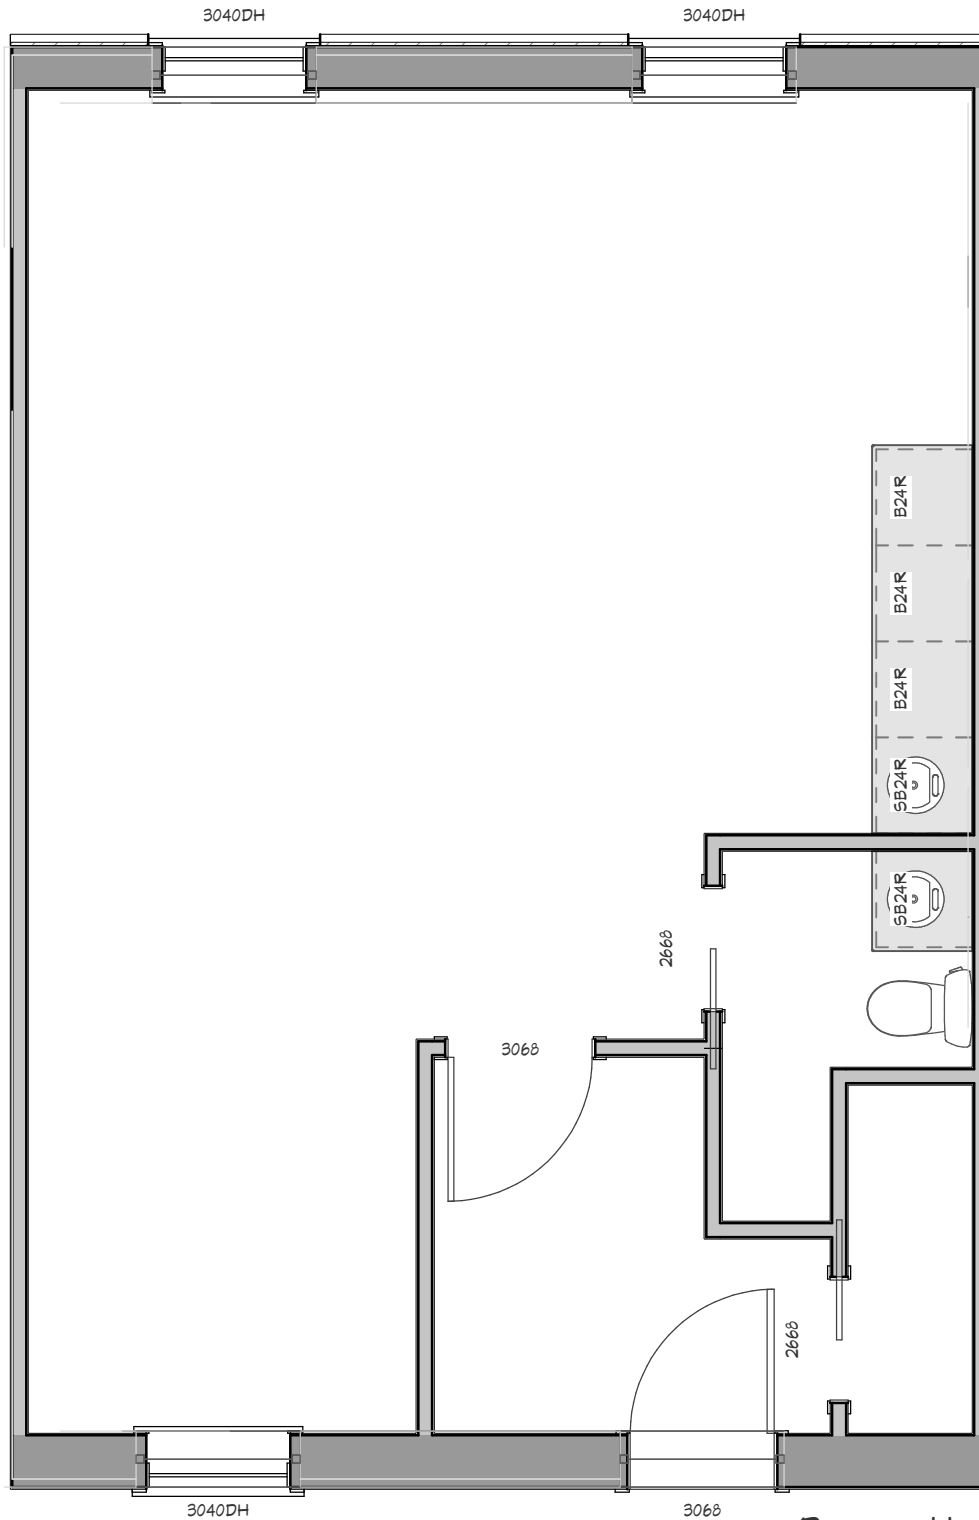

Prepared by DVP

***all dimensions are approximate*

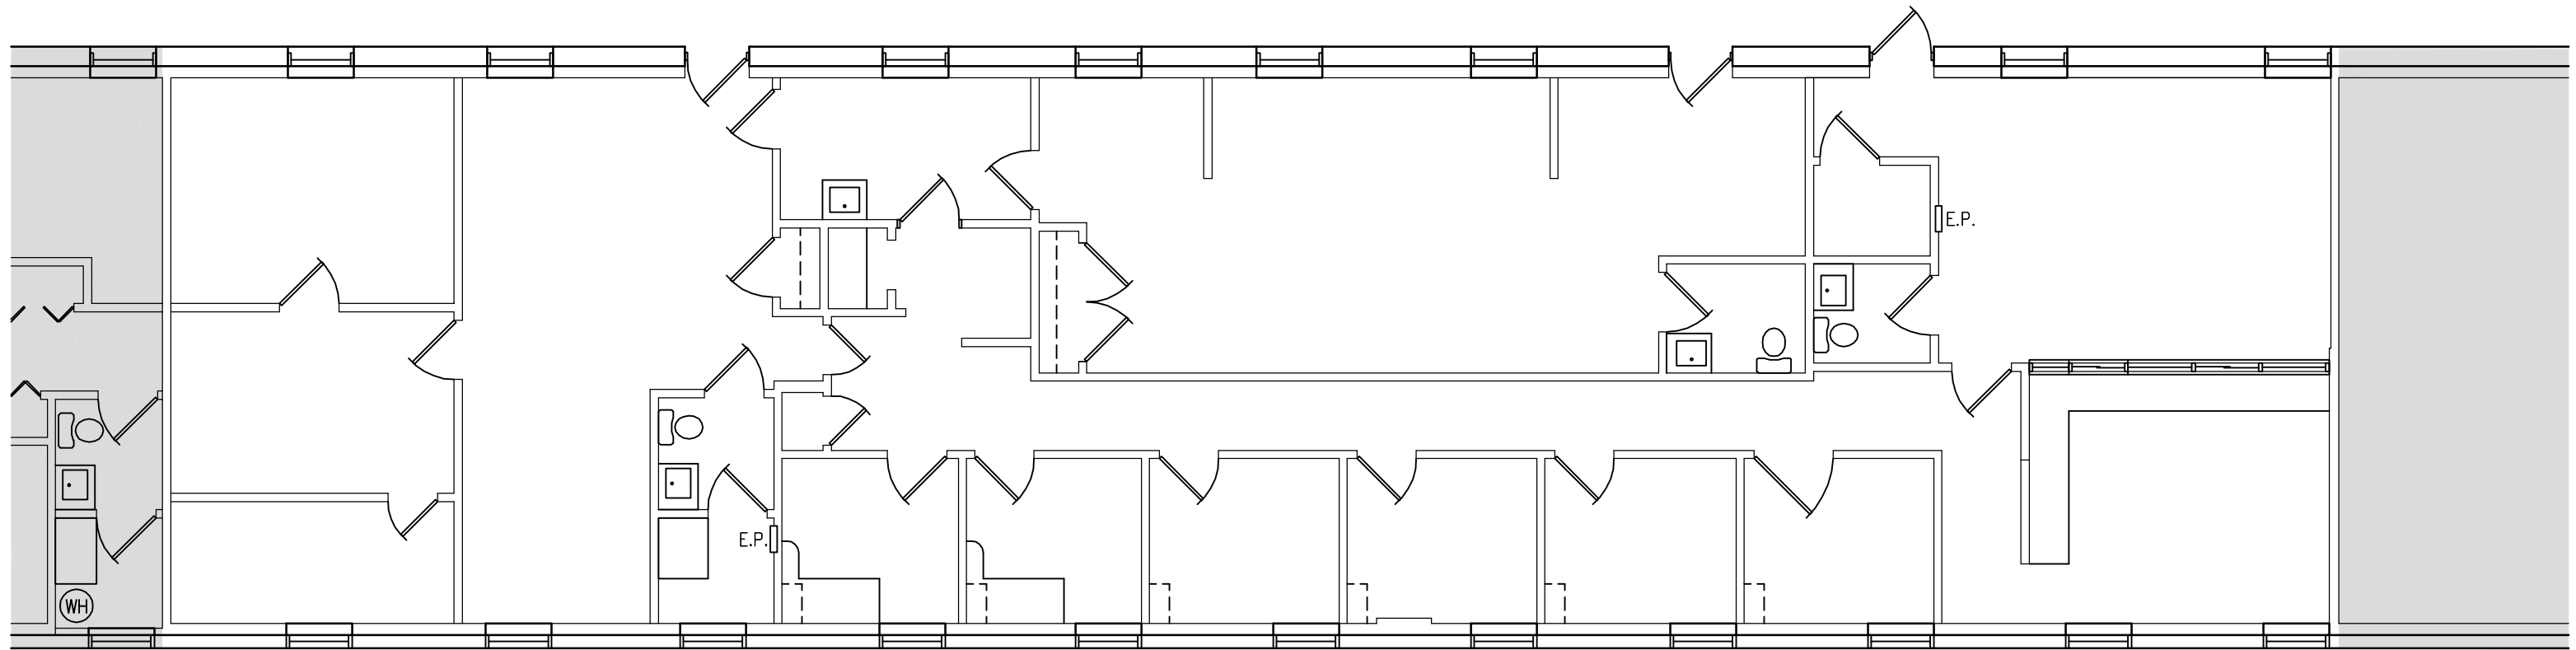

PARETTE
SOMJEN



ARCHITECTS
A LIMITED LIABILITY CORPORATION

439 Route 46 East
Rockaway, NJ 07866
Tel. 973.586.2400
Fax. 973.586.2401
www.planetPSA.com

EXISTING CONDITIONS EXHIBIT FOR:
**PARAGANO REAL ESTATE MANAGEMENT
IDEAL PROFESSIONAL PARK**
2333 MORRIS AVE.
UNION, NJ 07083

**SUITE A-214
SECOND FLOOR**


SCALE: 1/8" = 1'-0"

EHN
PROJECT MANAGER
AB
DRAWN BY
7309
PROJECT NUMBER
5 JUNE 2017
RELEASE DATE

SHEET NUMBER

A-214

© COPYRIGHT 2016 PARETTE SOMJEN ARCHITECTS LLC.

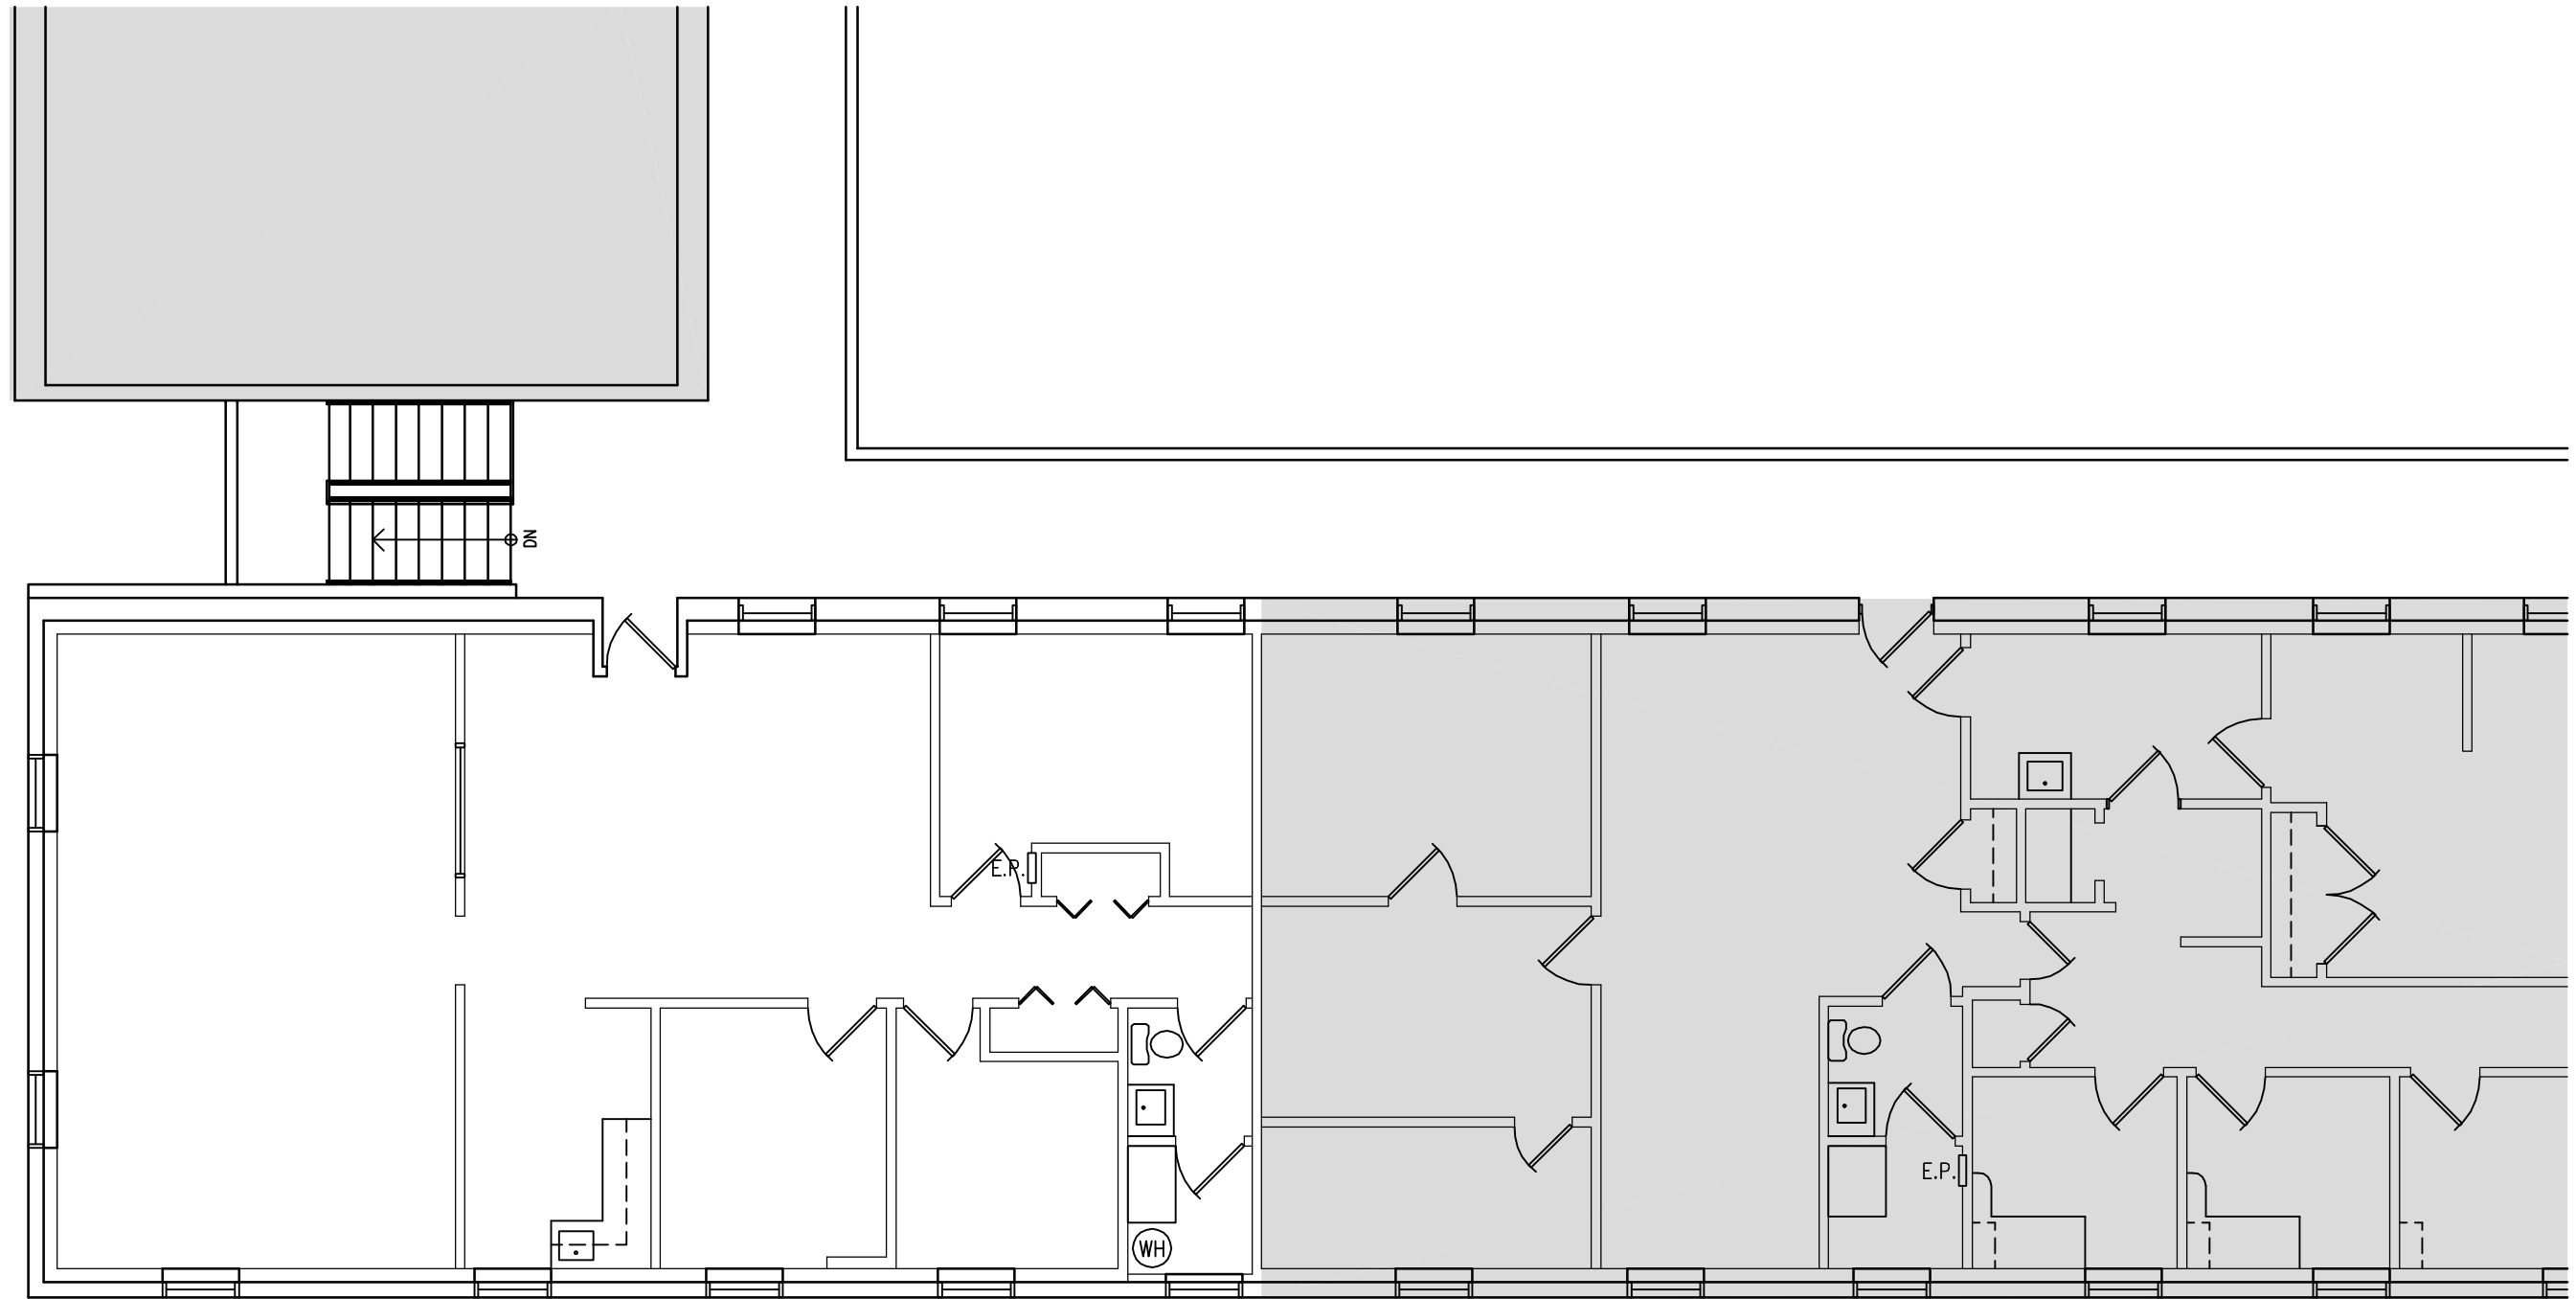

PARETTE
SOMJEN



ARCHITECTS
A LIMITED LIABILITY CORPORATION

439 Route 46 East
Rockaway, NJ 07866
Tel. 973.586.2400
Fax. 973.586.2401
www.planetPSA.com

EXISTING CONDITIONS EXHIBIT FOR:
**PARAGANO REAL ESTATE MANAGEMENT
IDEAL PROFESSIONAL PARK**

2333 MORRIS AVE.
UNION, NJ 07083

**SUITE A-220
SECOND FLOOR**

SCALE: 1/8" = 1'-0"

EHN
PROJECT MANAGER

AB
DRAWN BY

7309
PROJECT NUMBER


5 JUNE 2017

RELEASE DATE © COPYRIGHT 2016 PARETTESOMJEN ARCHITECTS LLC.

SHEET NUMBER

A-220

IDEAL PROFESSIONAL PARK
SUITE B-109: As-builts
SCALE: 1/8"=1'
2,352 sqft

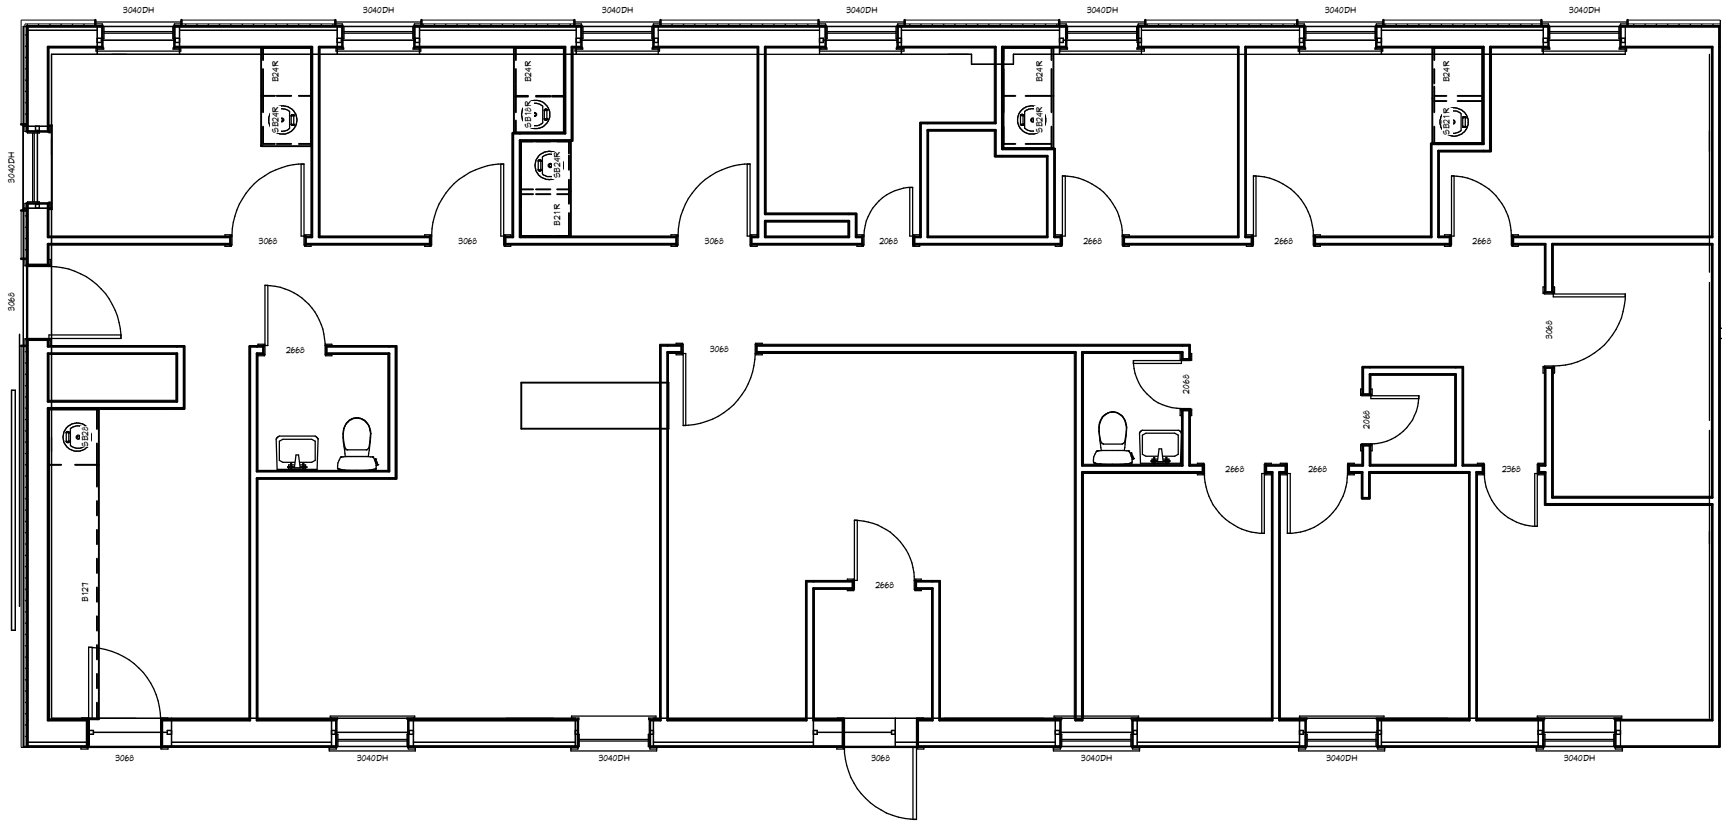

Prepared by DVP
***all dimensions are approximate*