


IDEAL PROFESSIONAL PARK  
SUITE B-218: As-builts  
2,554 sqft  
Scale 1/8" = 1'

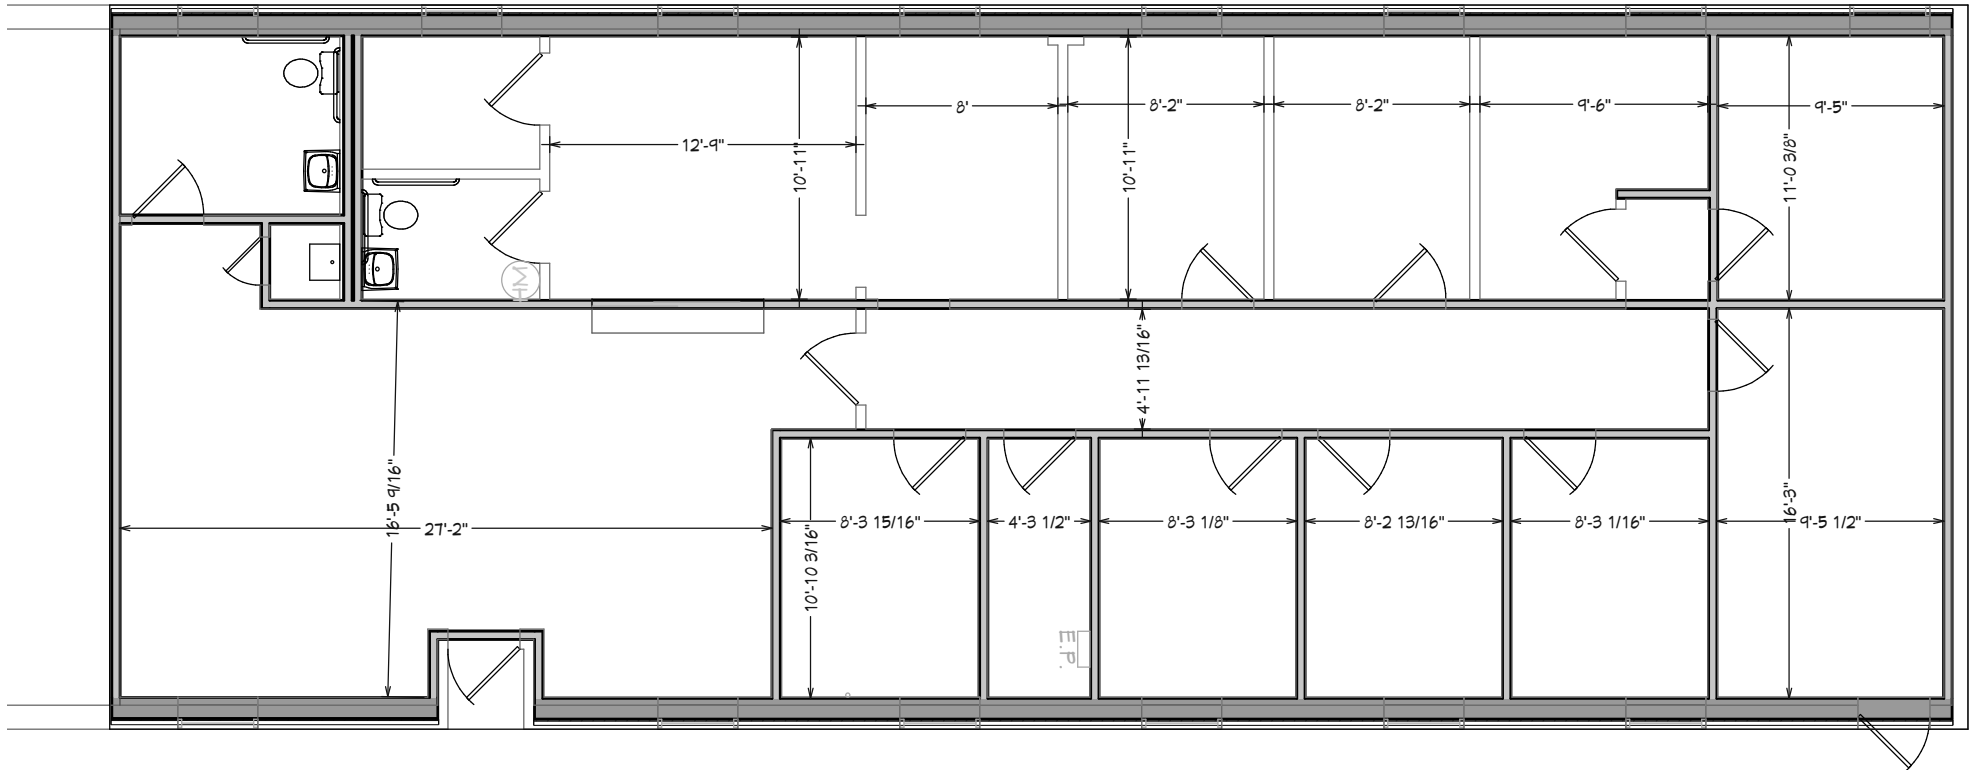


# IDEAL PROFESSIONAL PARK


Suite B-222: as-builts

SCALE: 1/4"=1'

806 sqft

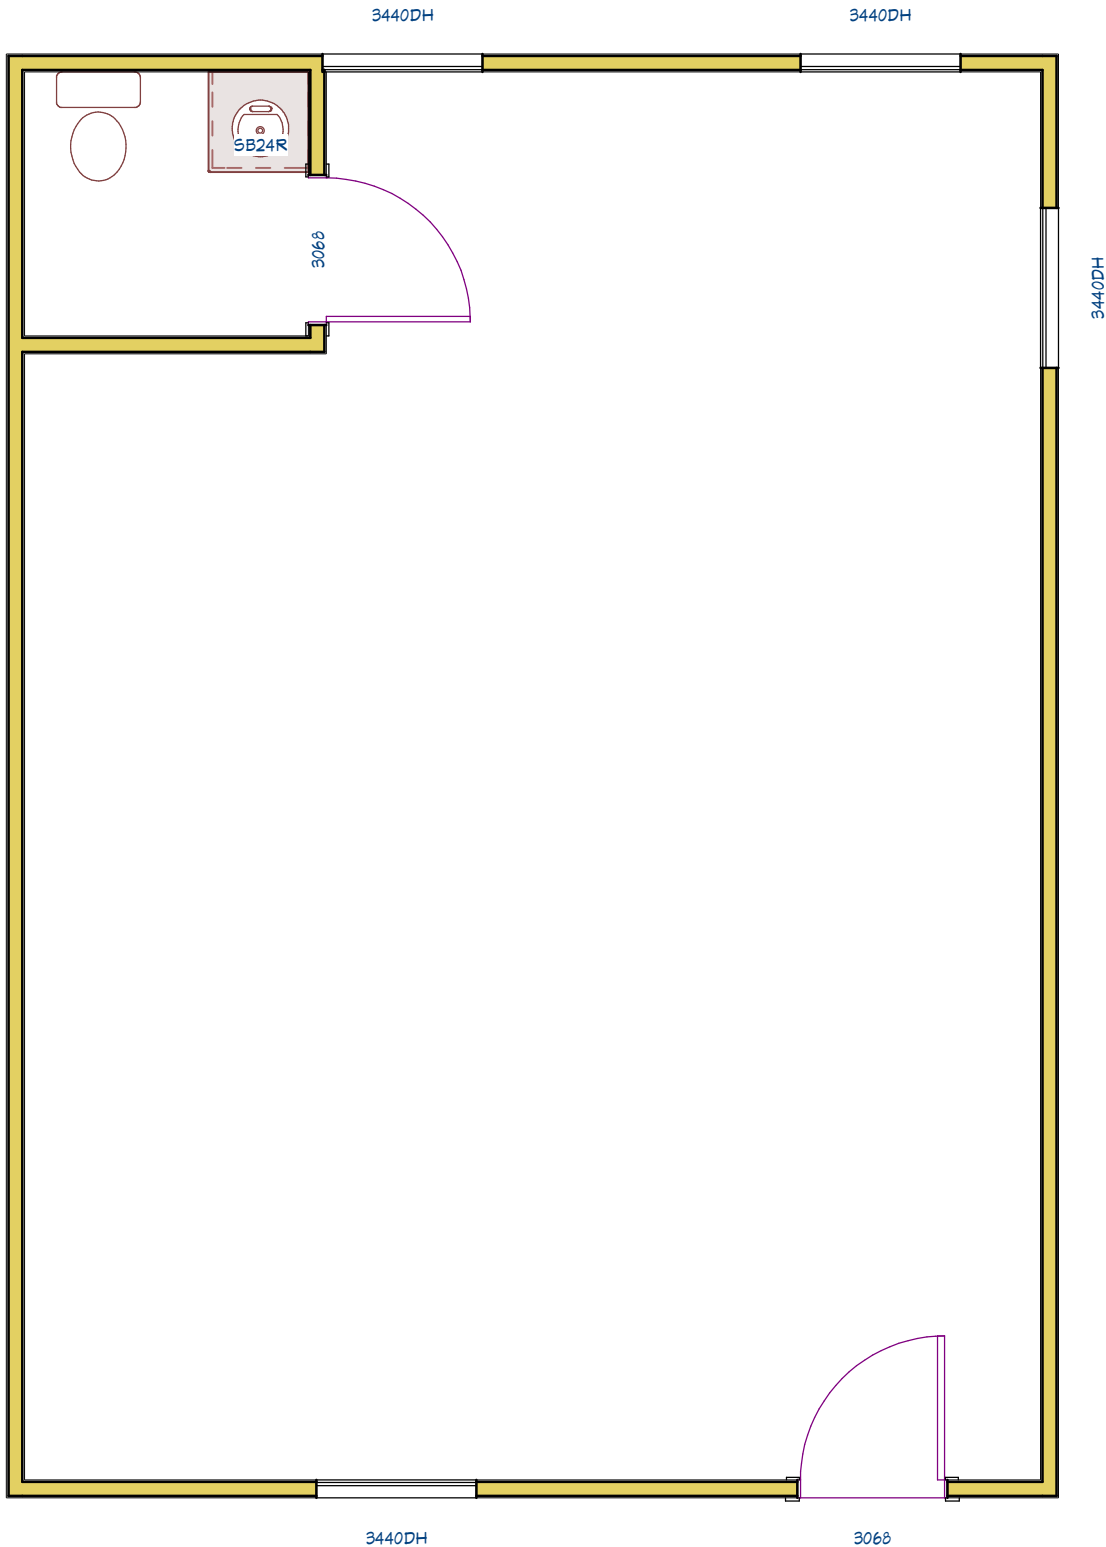

IDEAL PROFESSIONAL PARK  
SUITE D-206/208: As-builts  
SCALE: 1"=15'  
3,360 SQFT

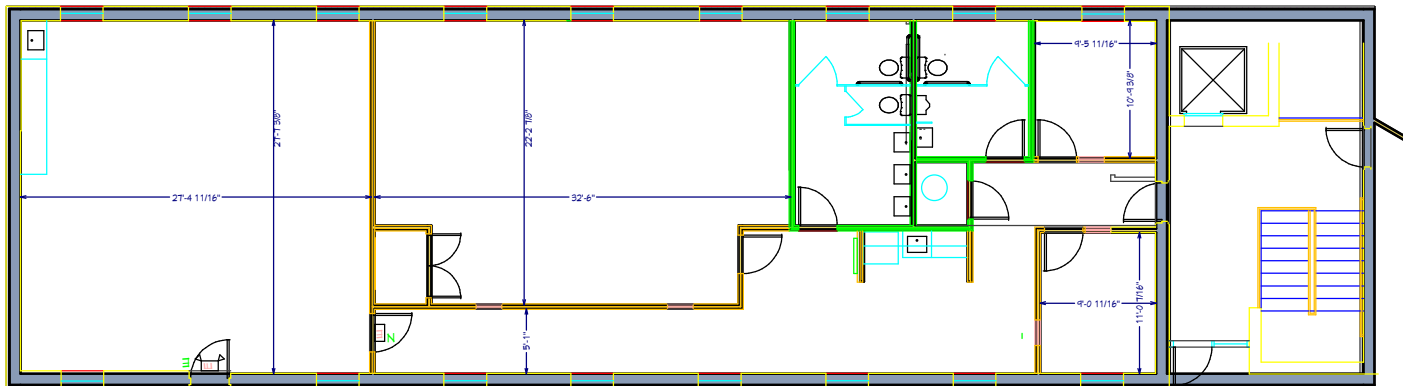

Prepared by DVP  
*\*\*all dimensions are approximate*

IDEAL PROFESSIONAL PARK  
SUITES D-214 and D-216: As-builts  
SCALE: 1/8"=1'  
1,344 SQFT

